
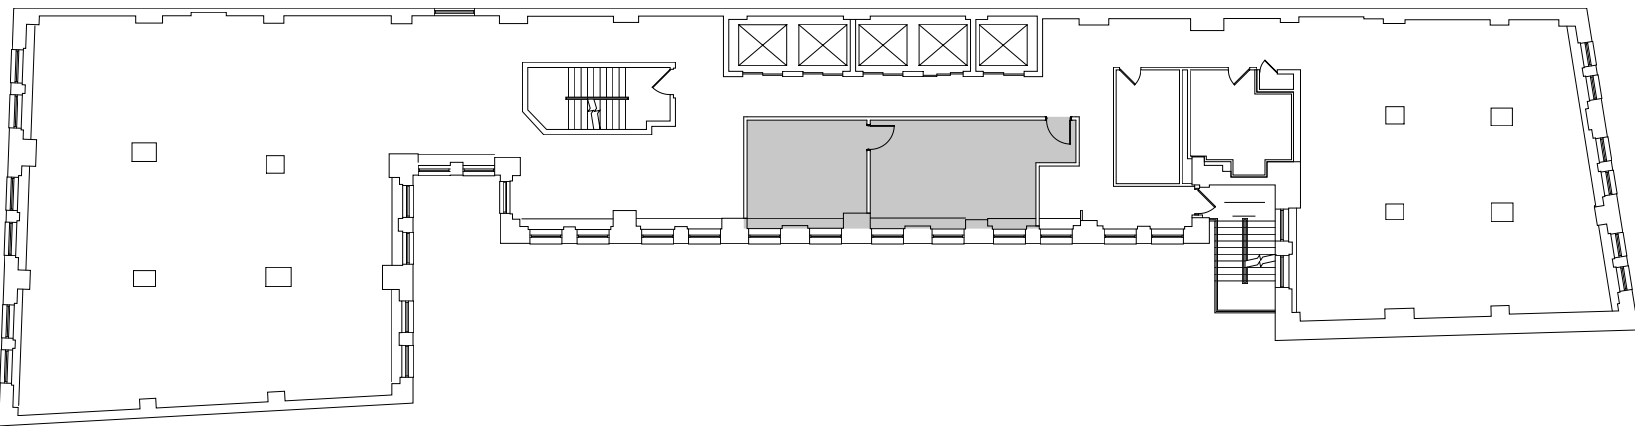


32 BROADWAY

FLOOR 14 - SUITE 1408

882 RSF

CORE AND SHELL

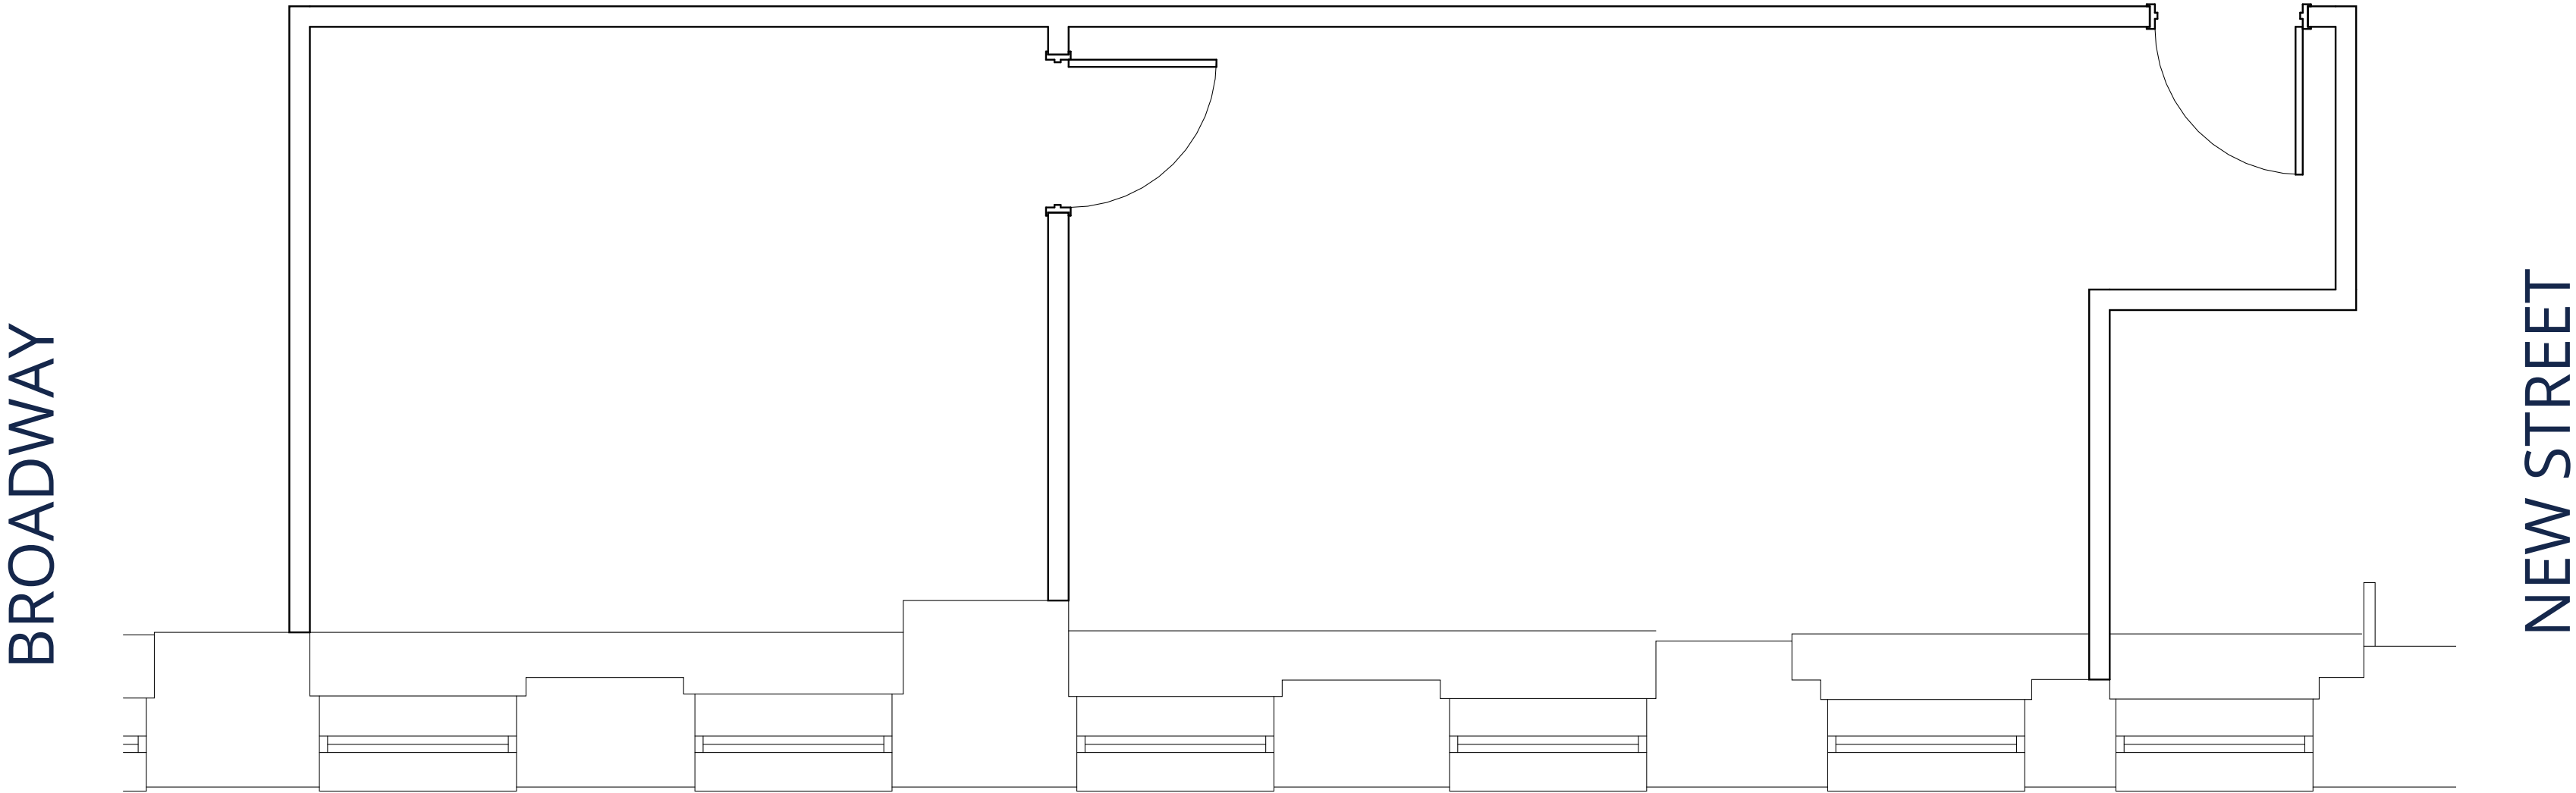

Restaurant on premises		Walking distance to public transportation	
11'6" Slab to Slab Height		Financial District - Downtown Orbit	