
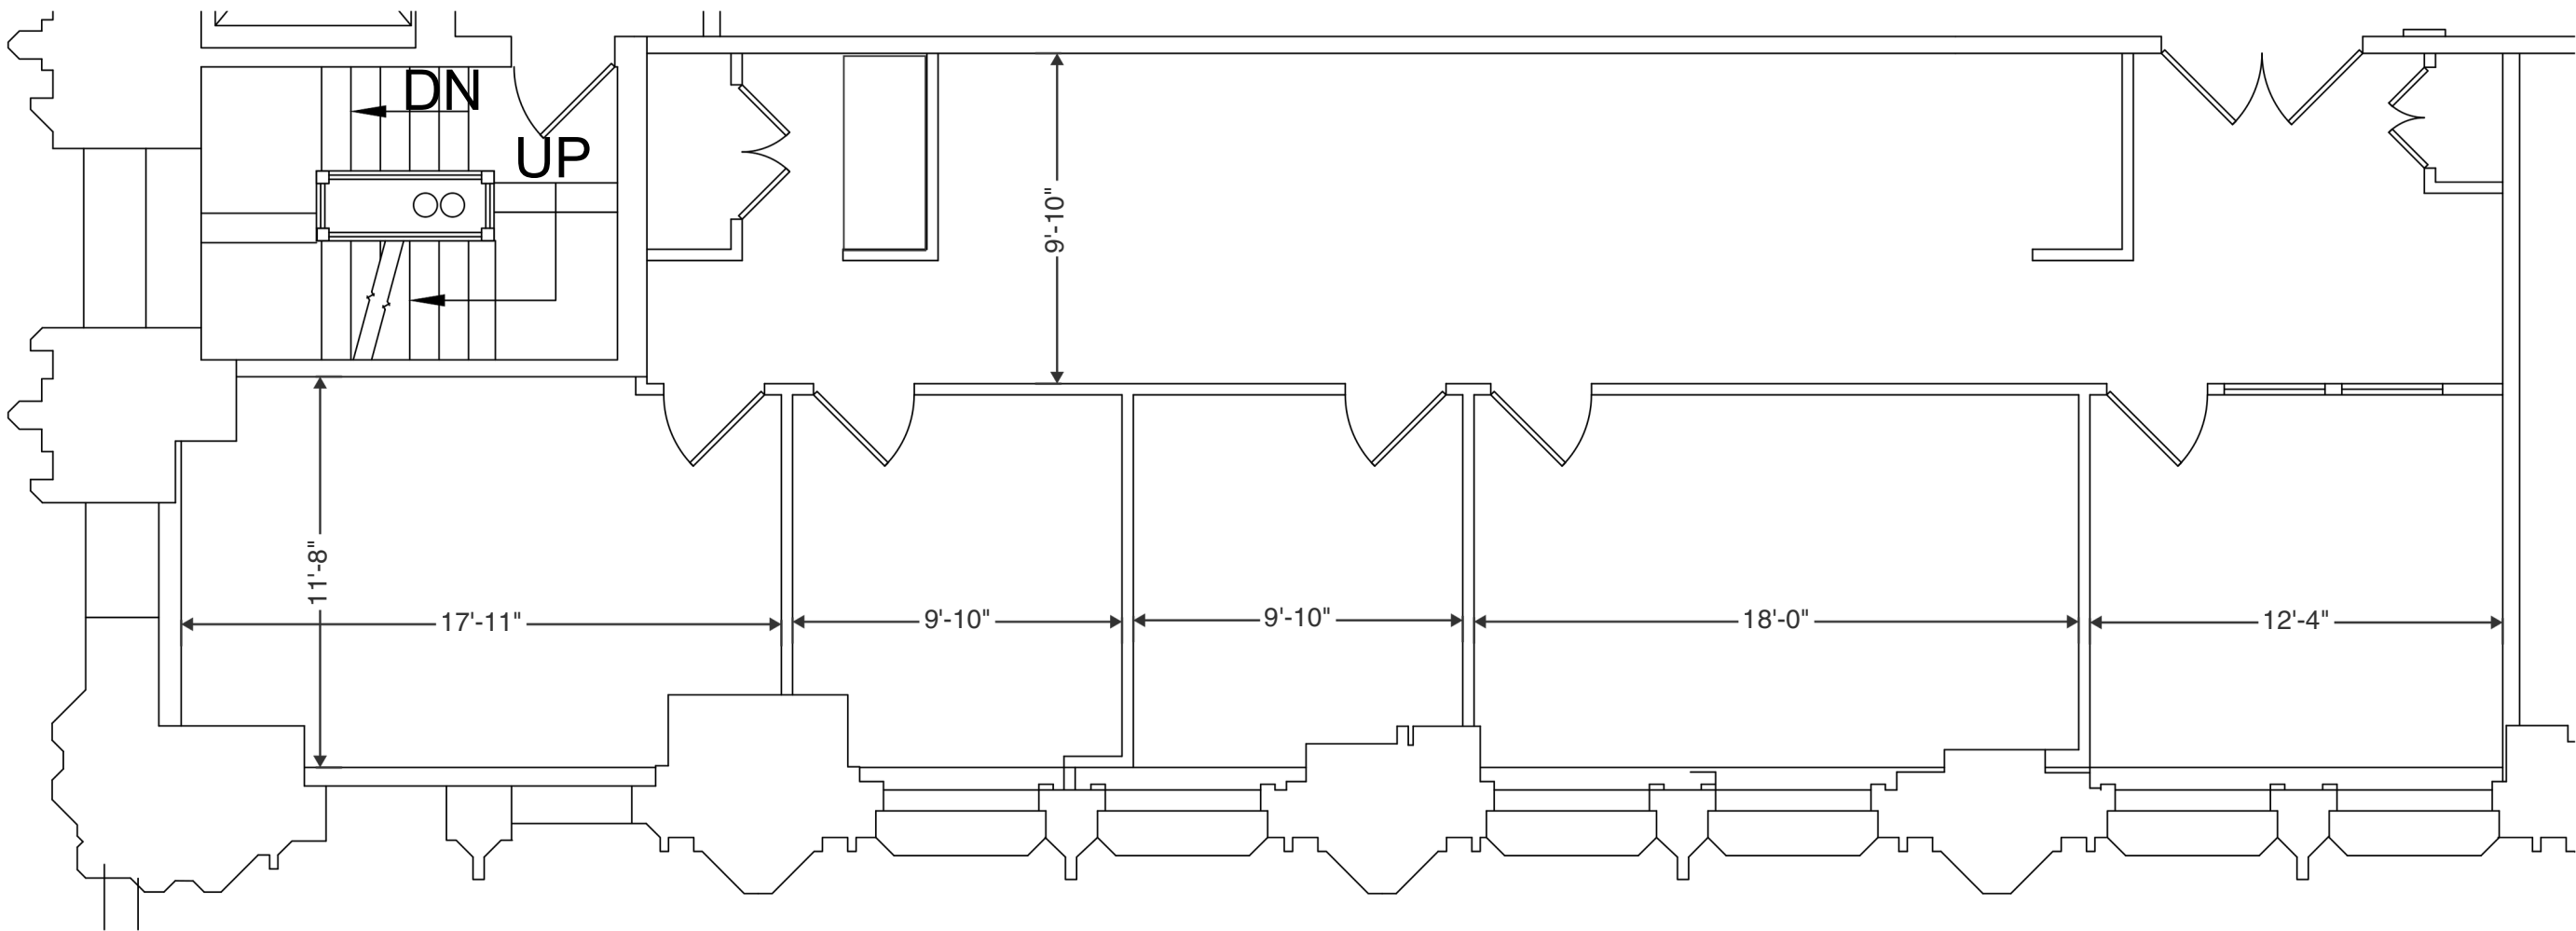


233 BROADWAY
8TH FLOOR

SUITE 810

2,327 RSF

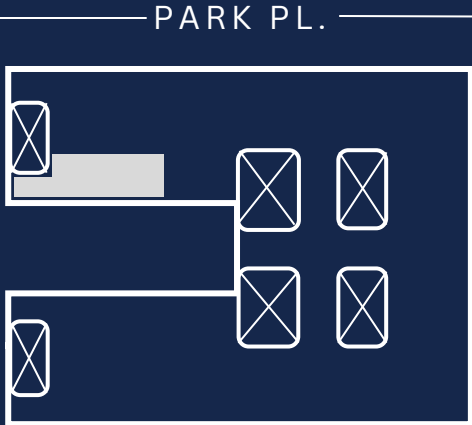

212-284-3756

www.cammebys.com

Cammeby's