
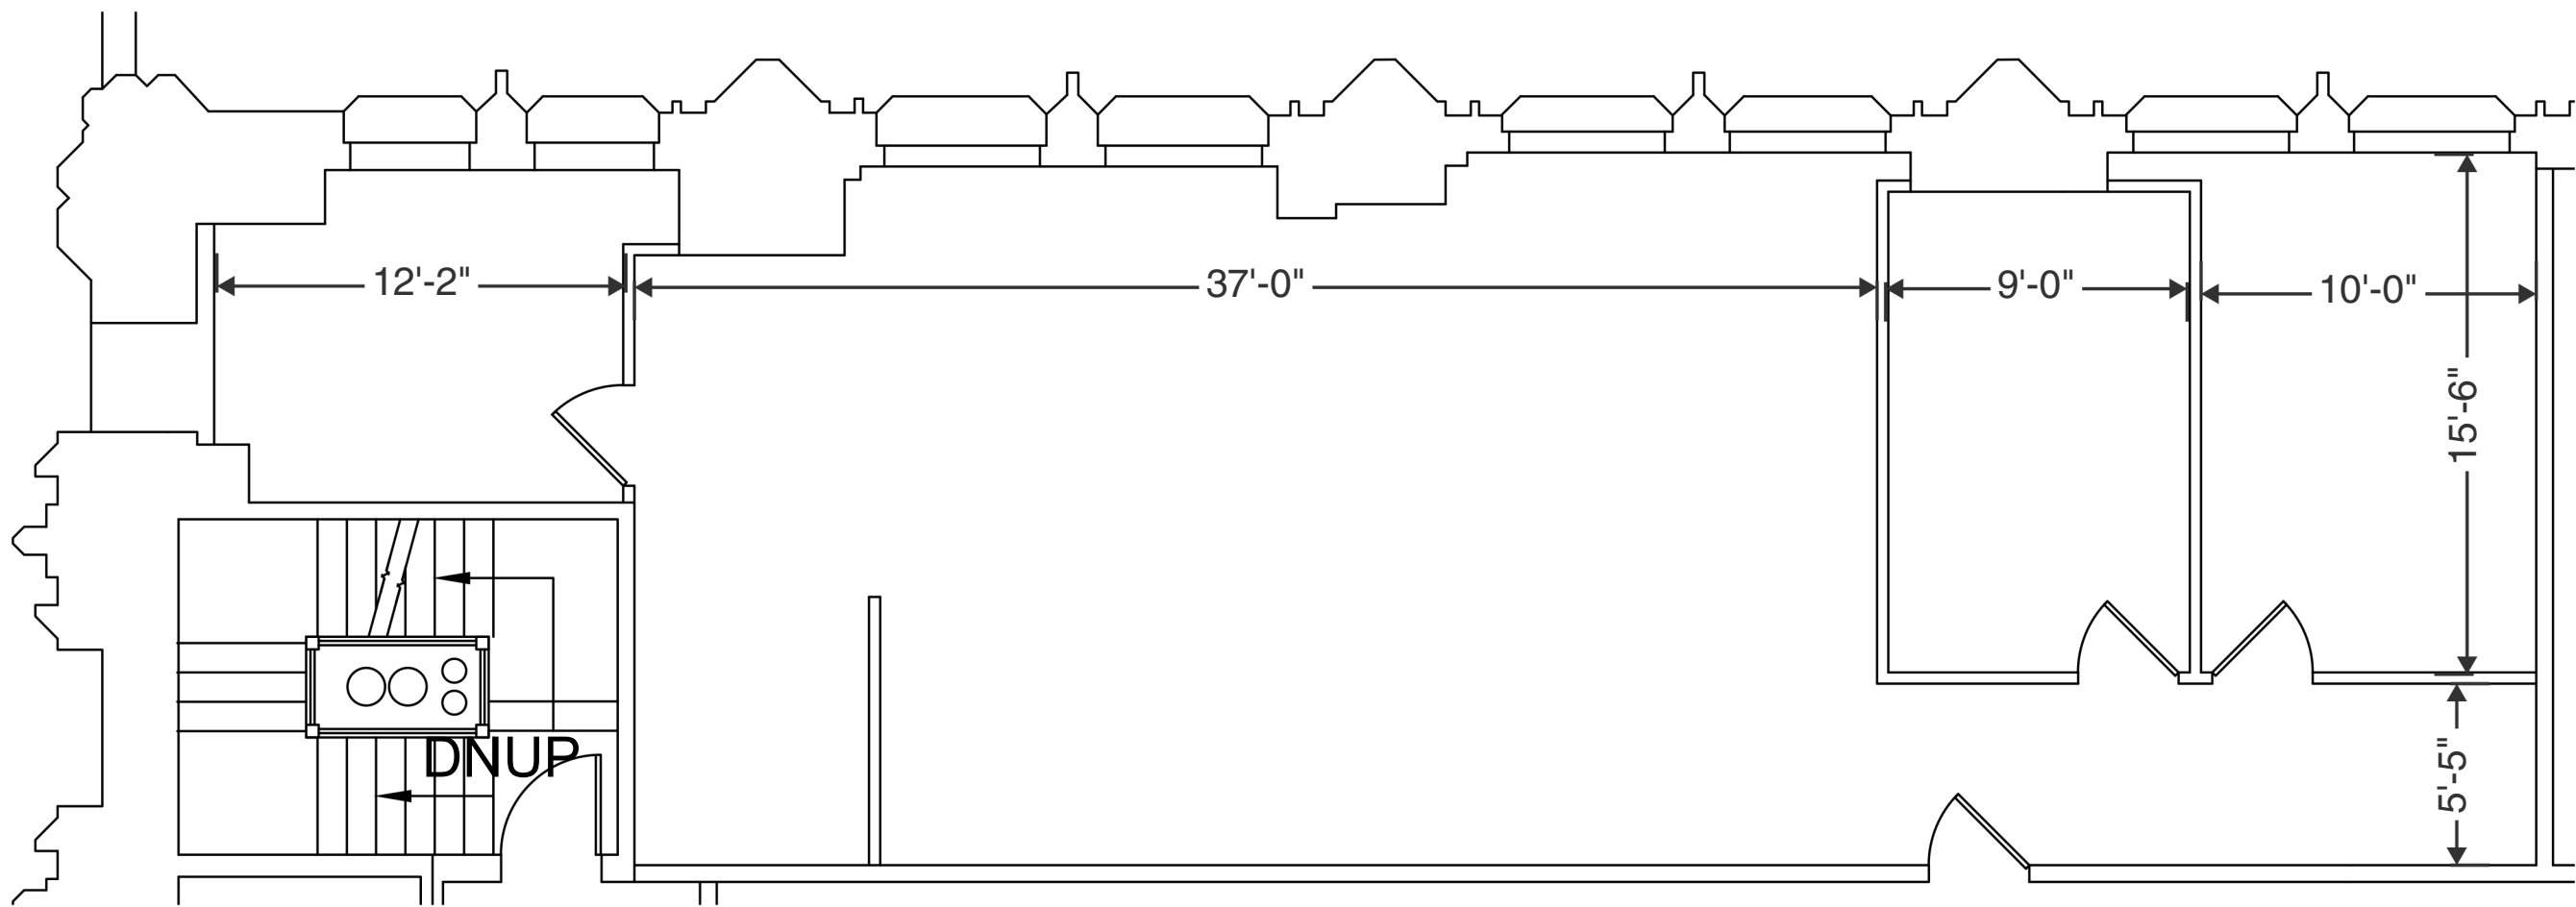


233 BROADWAY
8TH FLOOR

SUITE 860

2,217 RSF

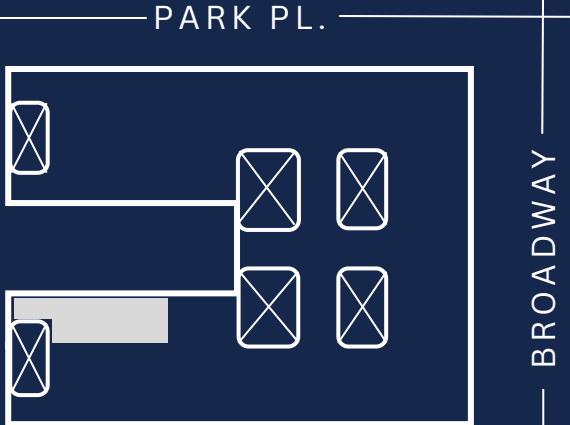

212-284-3756

www.cammebys.com

Cammeby's