


233 BROADWAY


17TH FLOOR

SUITE 1700 -AS BUILT

7,230 RSF

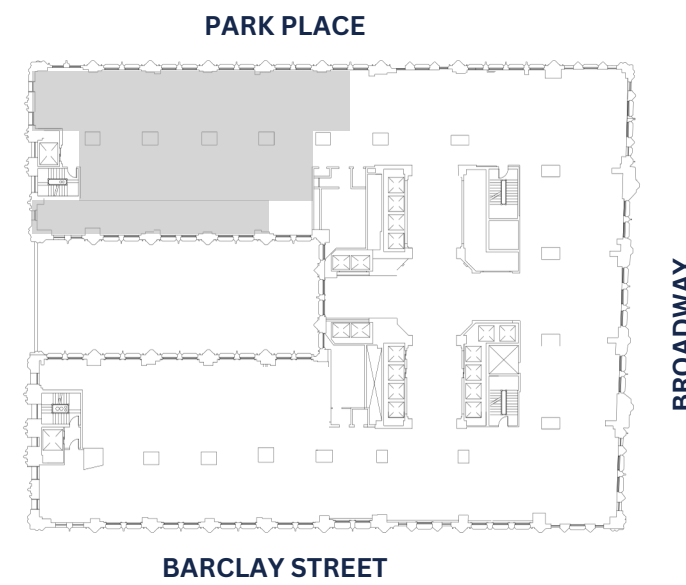

Landmark Skyscraper		Walking distance to public transportation	
Built Installation		Financial District - Downtown Orbit	

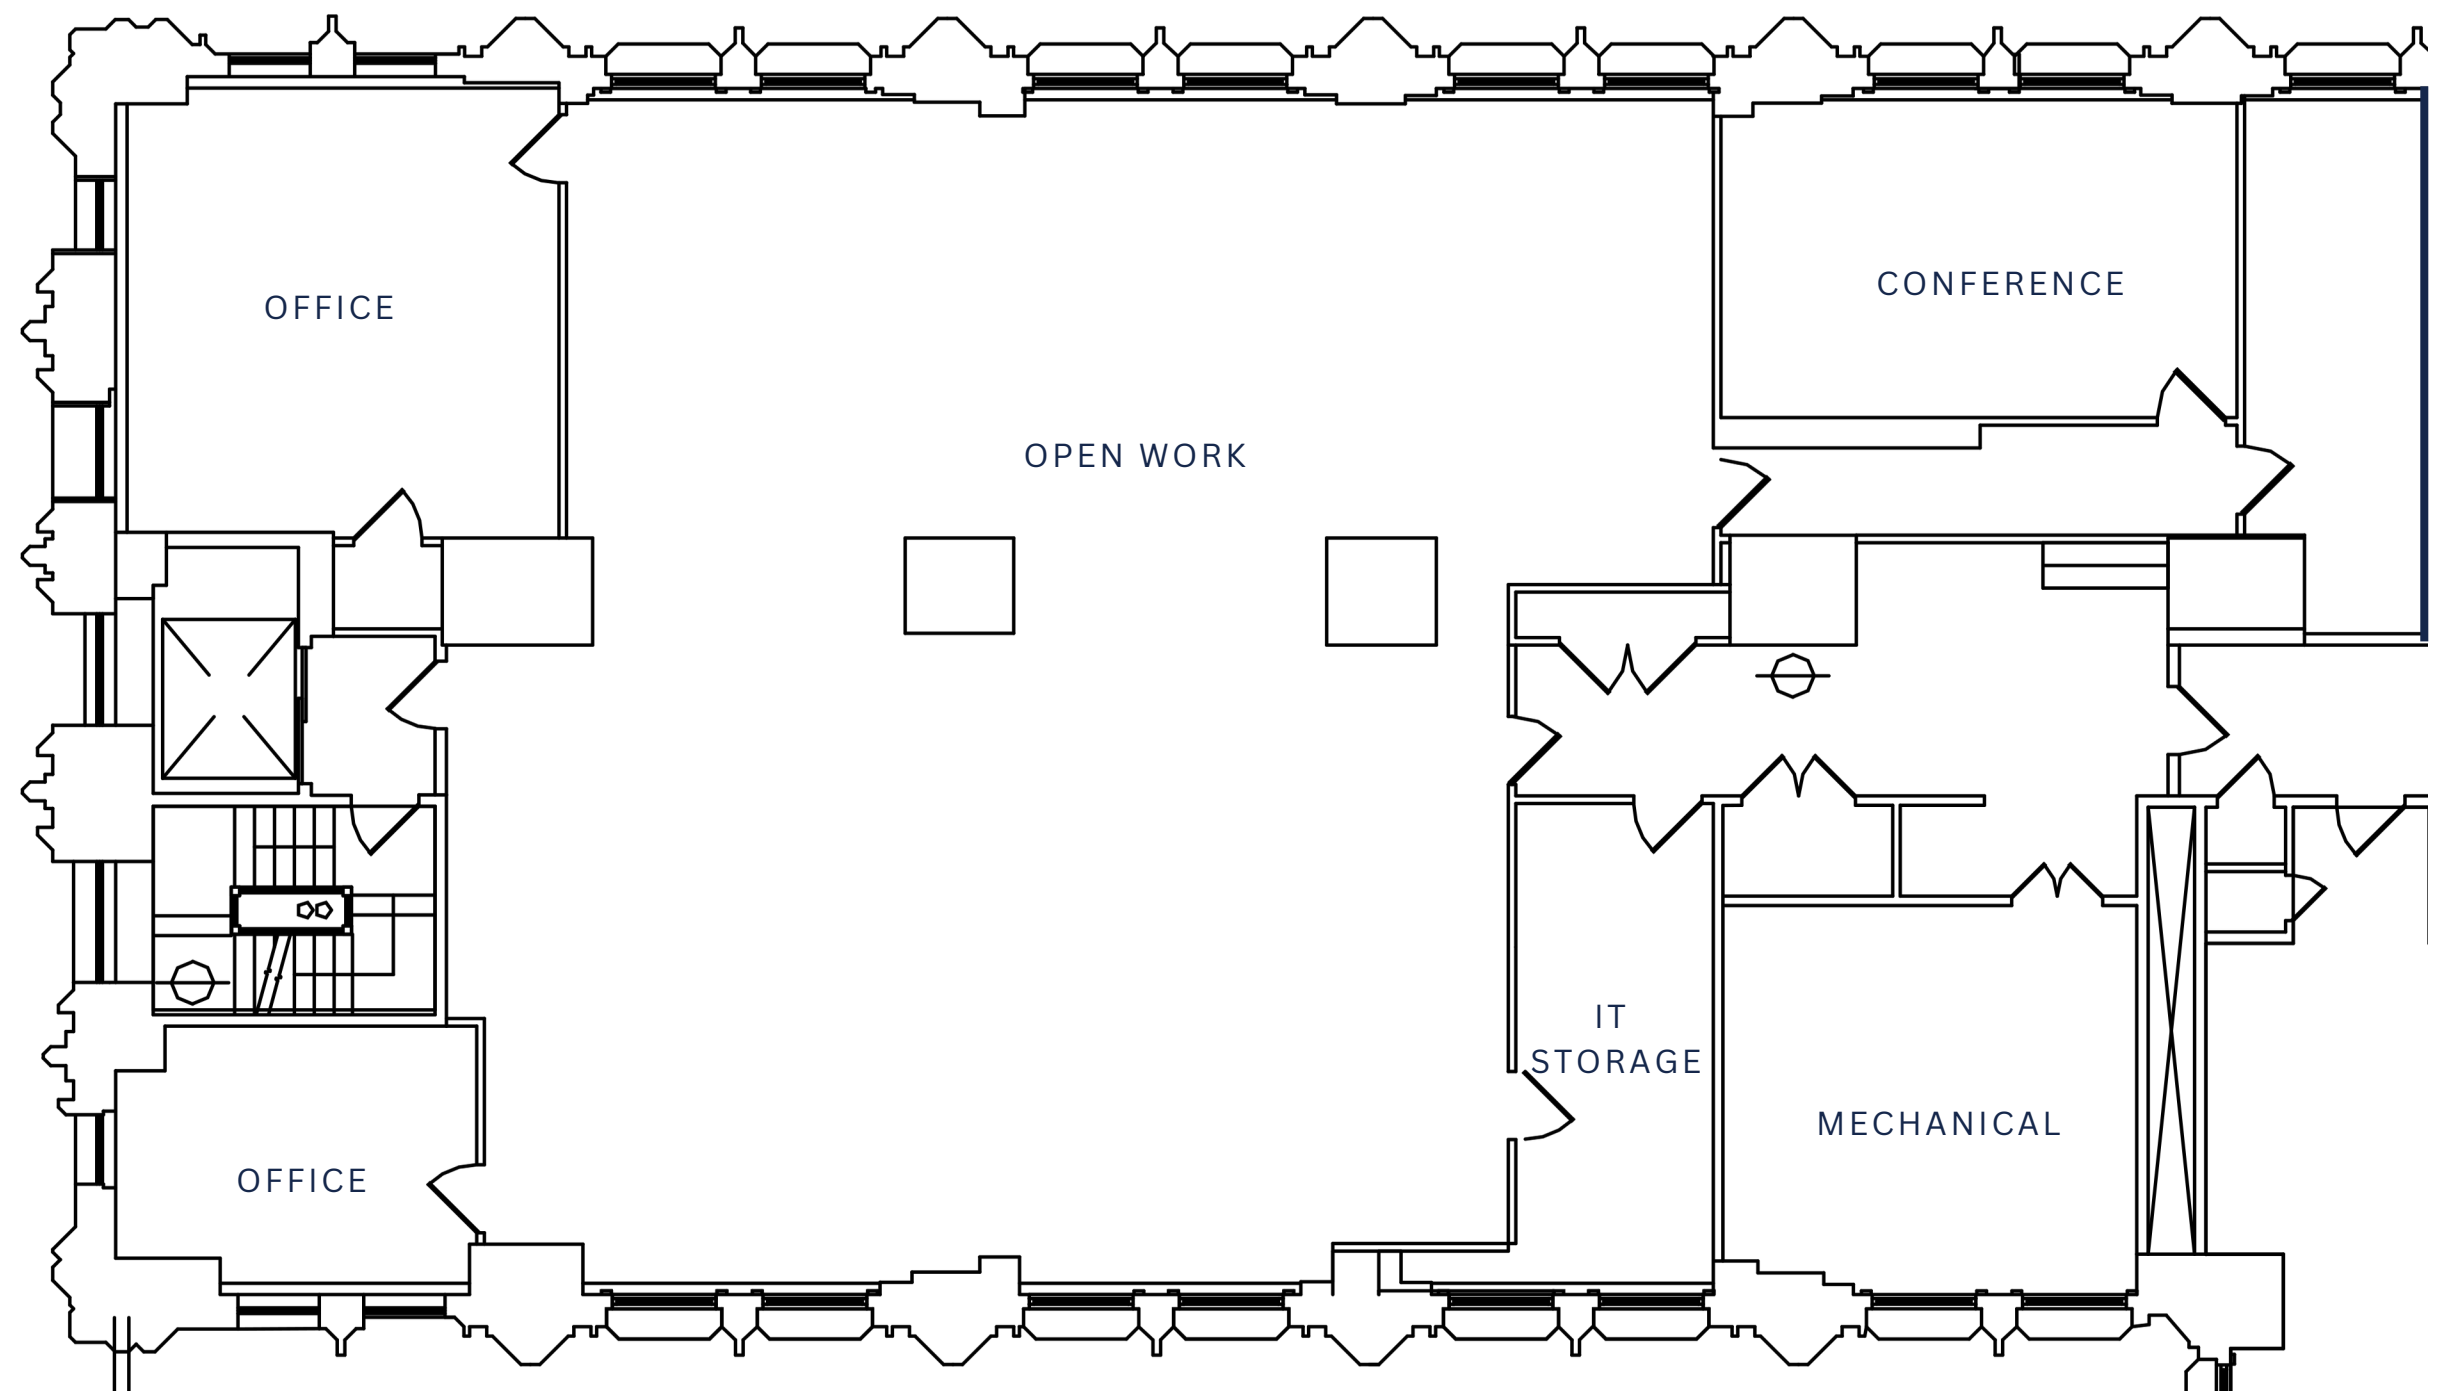

212-284-3756

Cammeby's

[www.cammebys.com](http://www.cammebys.com)