


45 BROADWAY

FLOOR 11 SUITE 1150

3,486 SF

AS BUILT

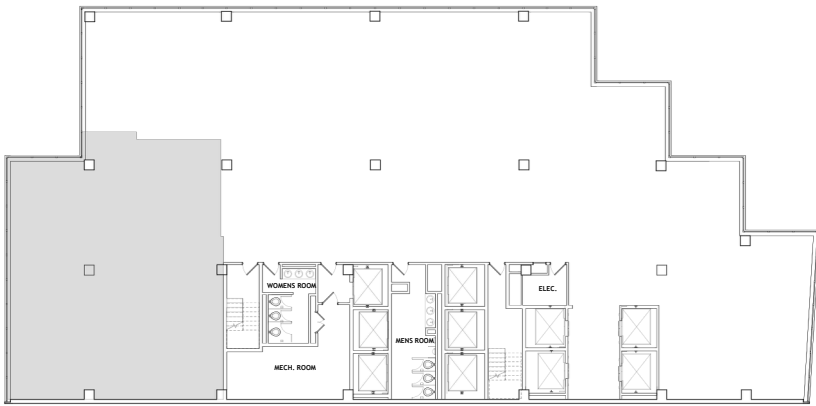

TRINITY

