
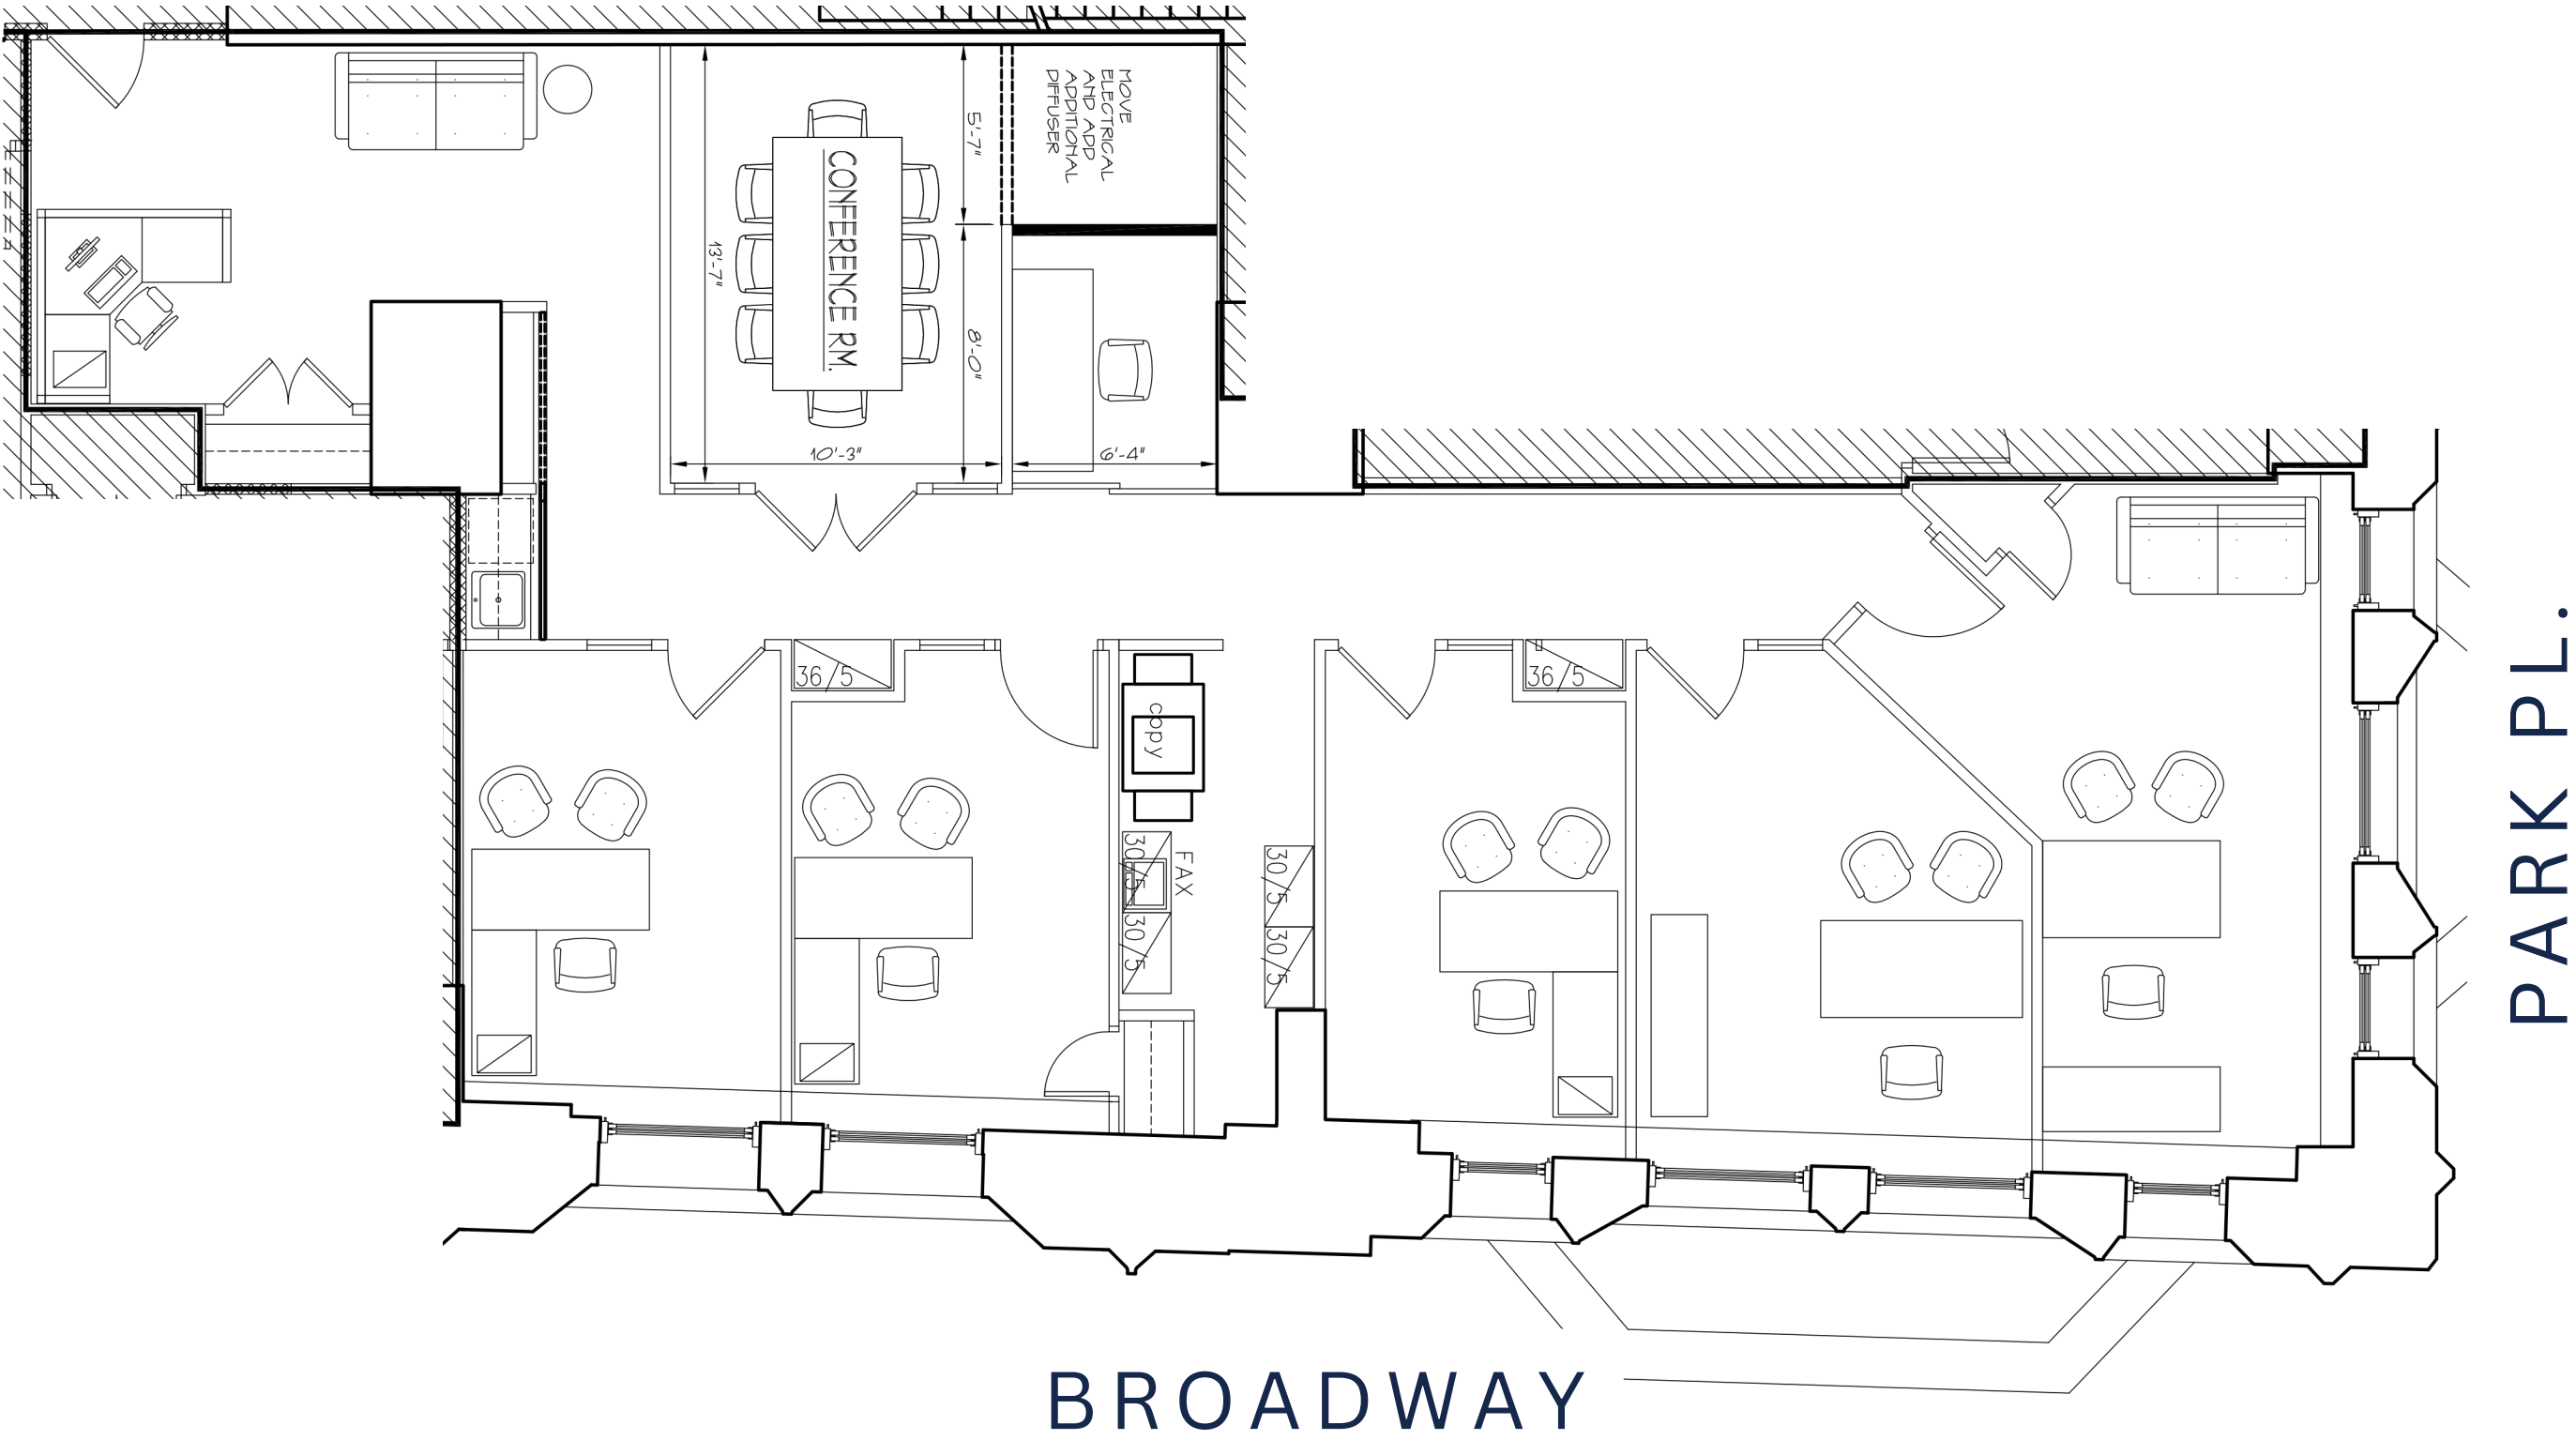


233 BROADWAY
27TH FLOOR

SUITE 2704

2,744 RSF

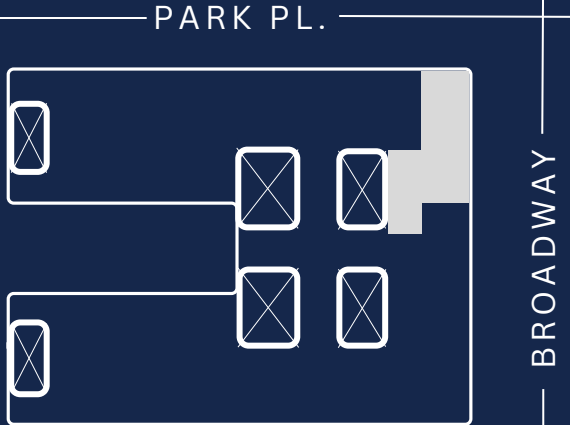

212-284-3756

www.cammebys.com

Cammeby's