
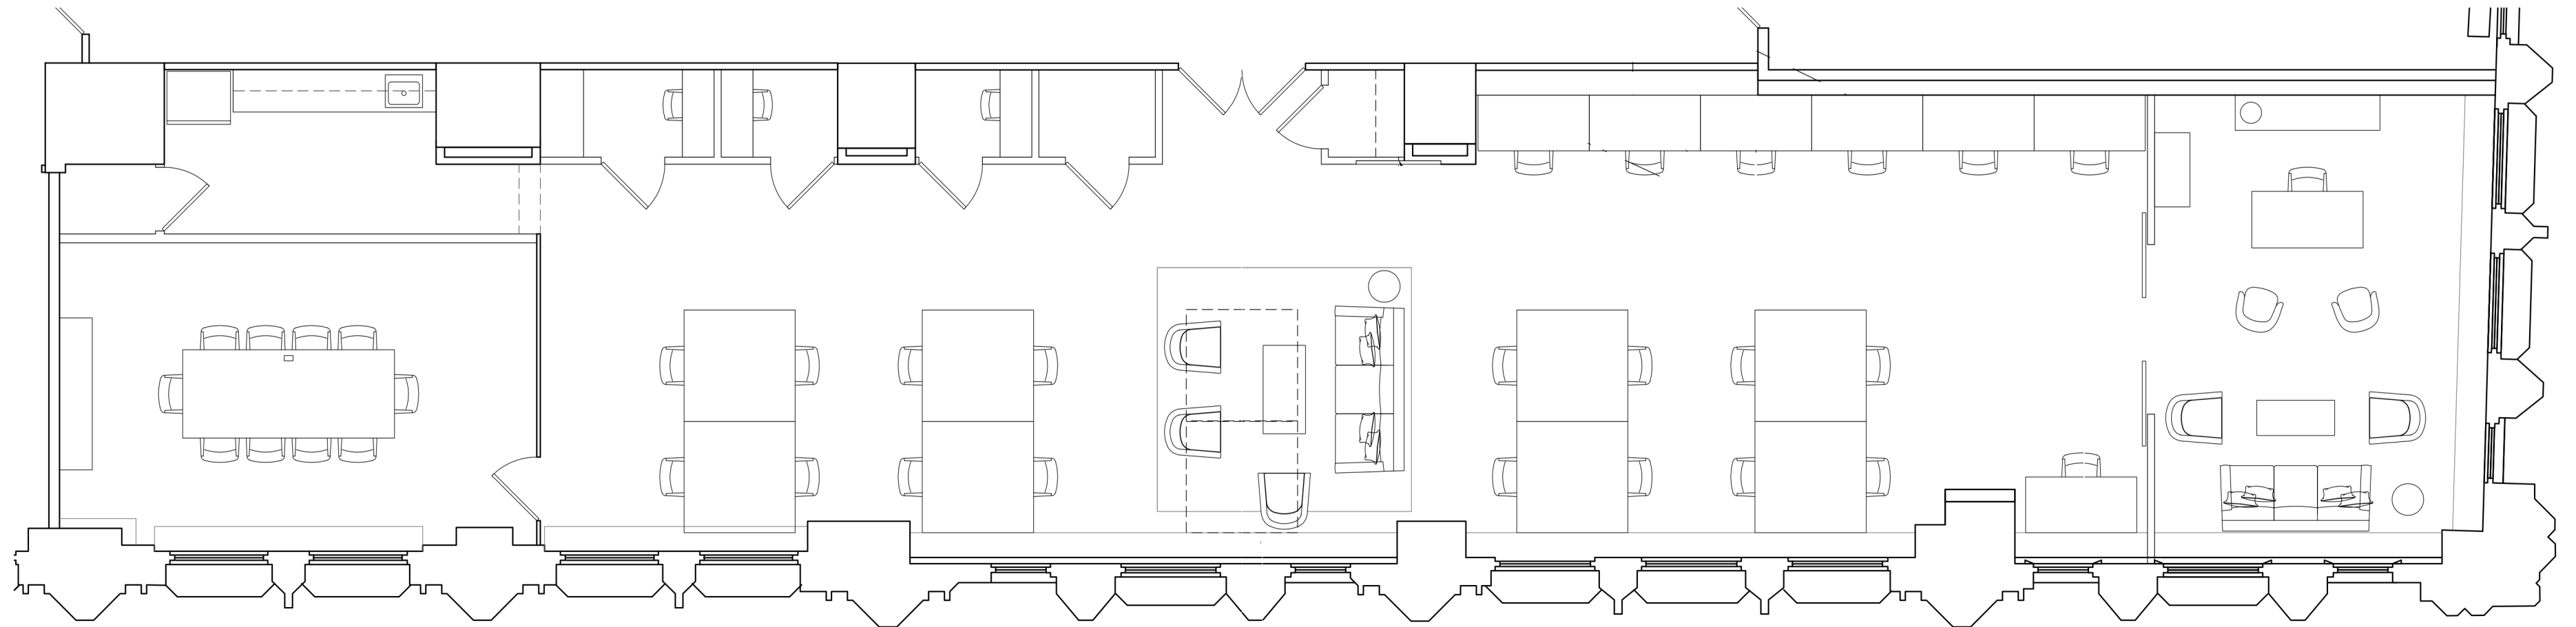


233 BROADWAY
21ST FLOOR

SUITE 2160

4461 RSF

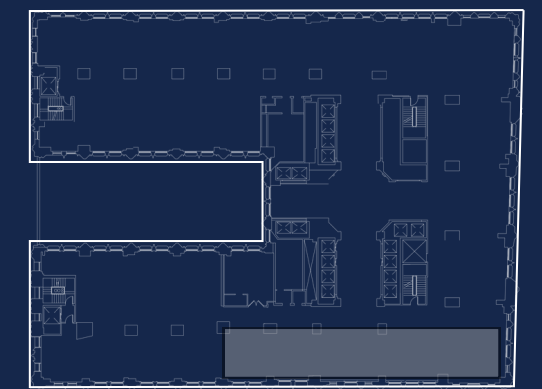

212-284-3756

www.cammebys.com

Cammeby's