


32 BROADWAY
FLOOR 15- SUITE 1514

2,000 RSF AS- BUILT

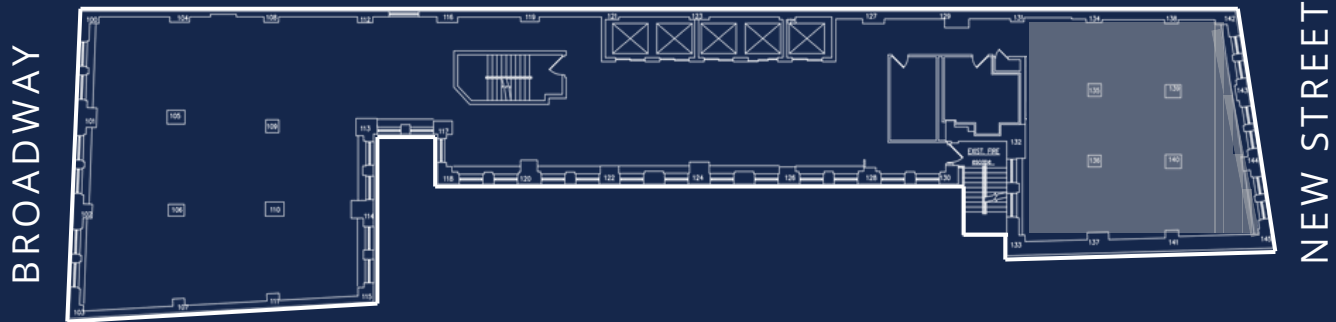

Workspace	Count
Reception	1
Offices	3
Conference	1

Support	Count
Pantry	1
Coat/Storage	2

