


39 BROADWAY


15TH FLOOR · SUITE 1540

2,600 RSF

AS BUILT

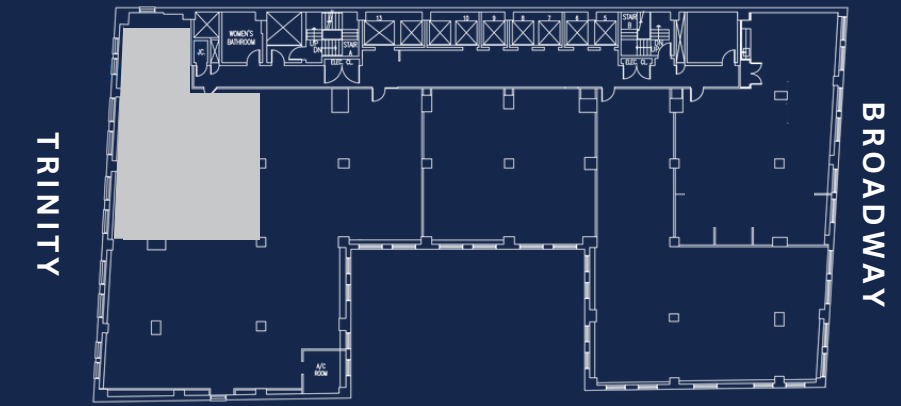

NOTE: All areas and dimensions are approximate. This plan is intended for illustration only.

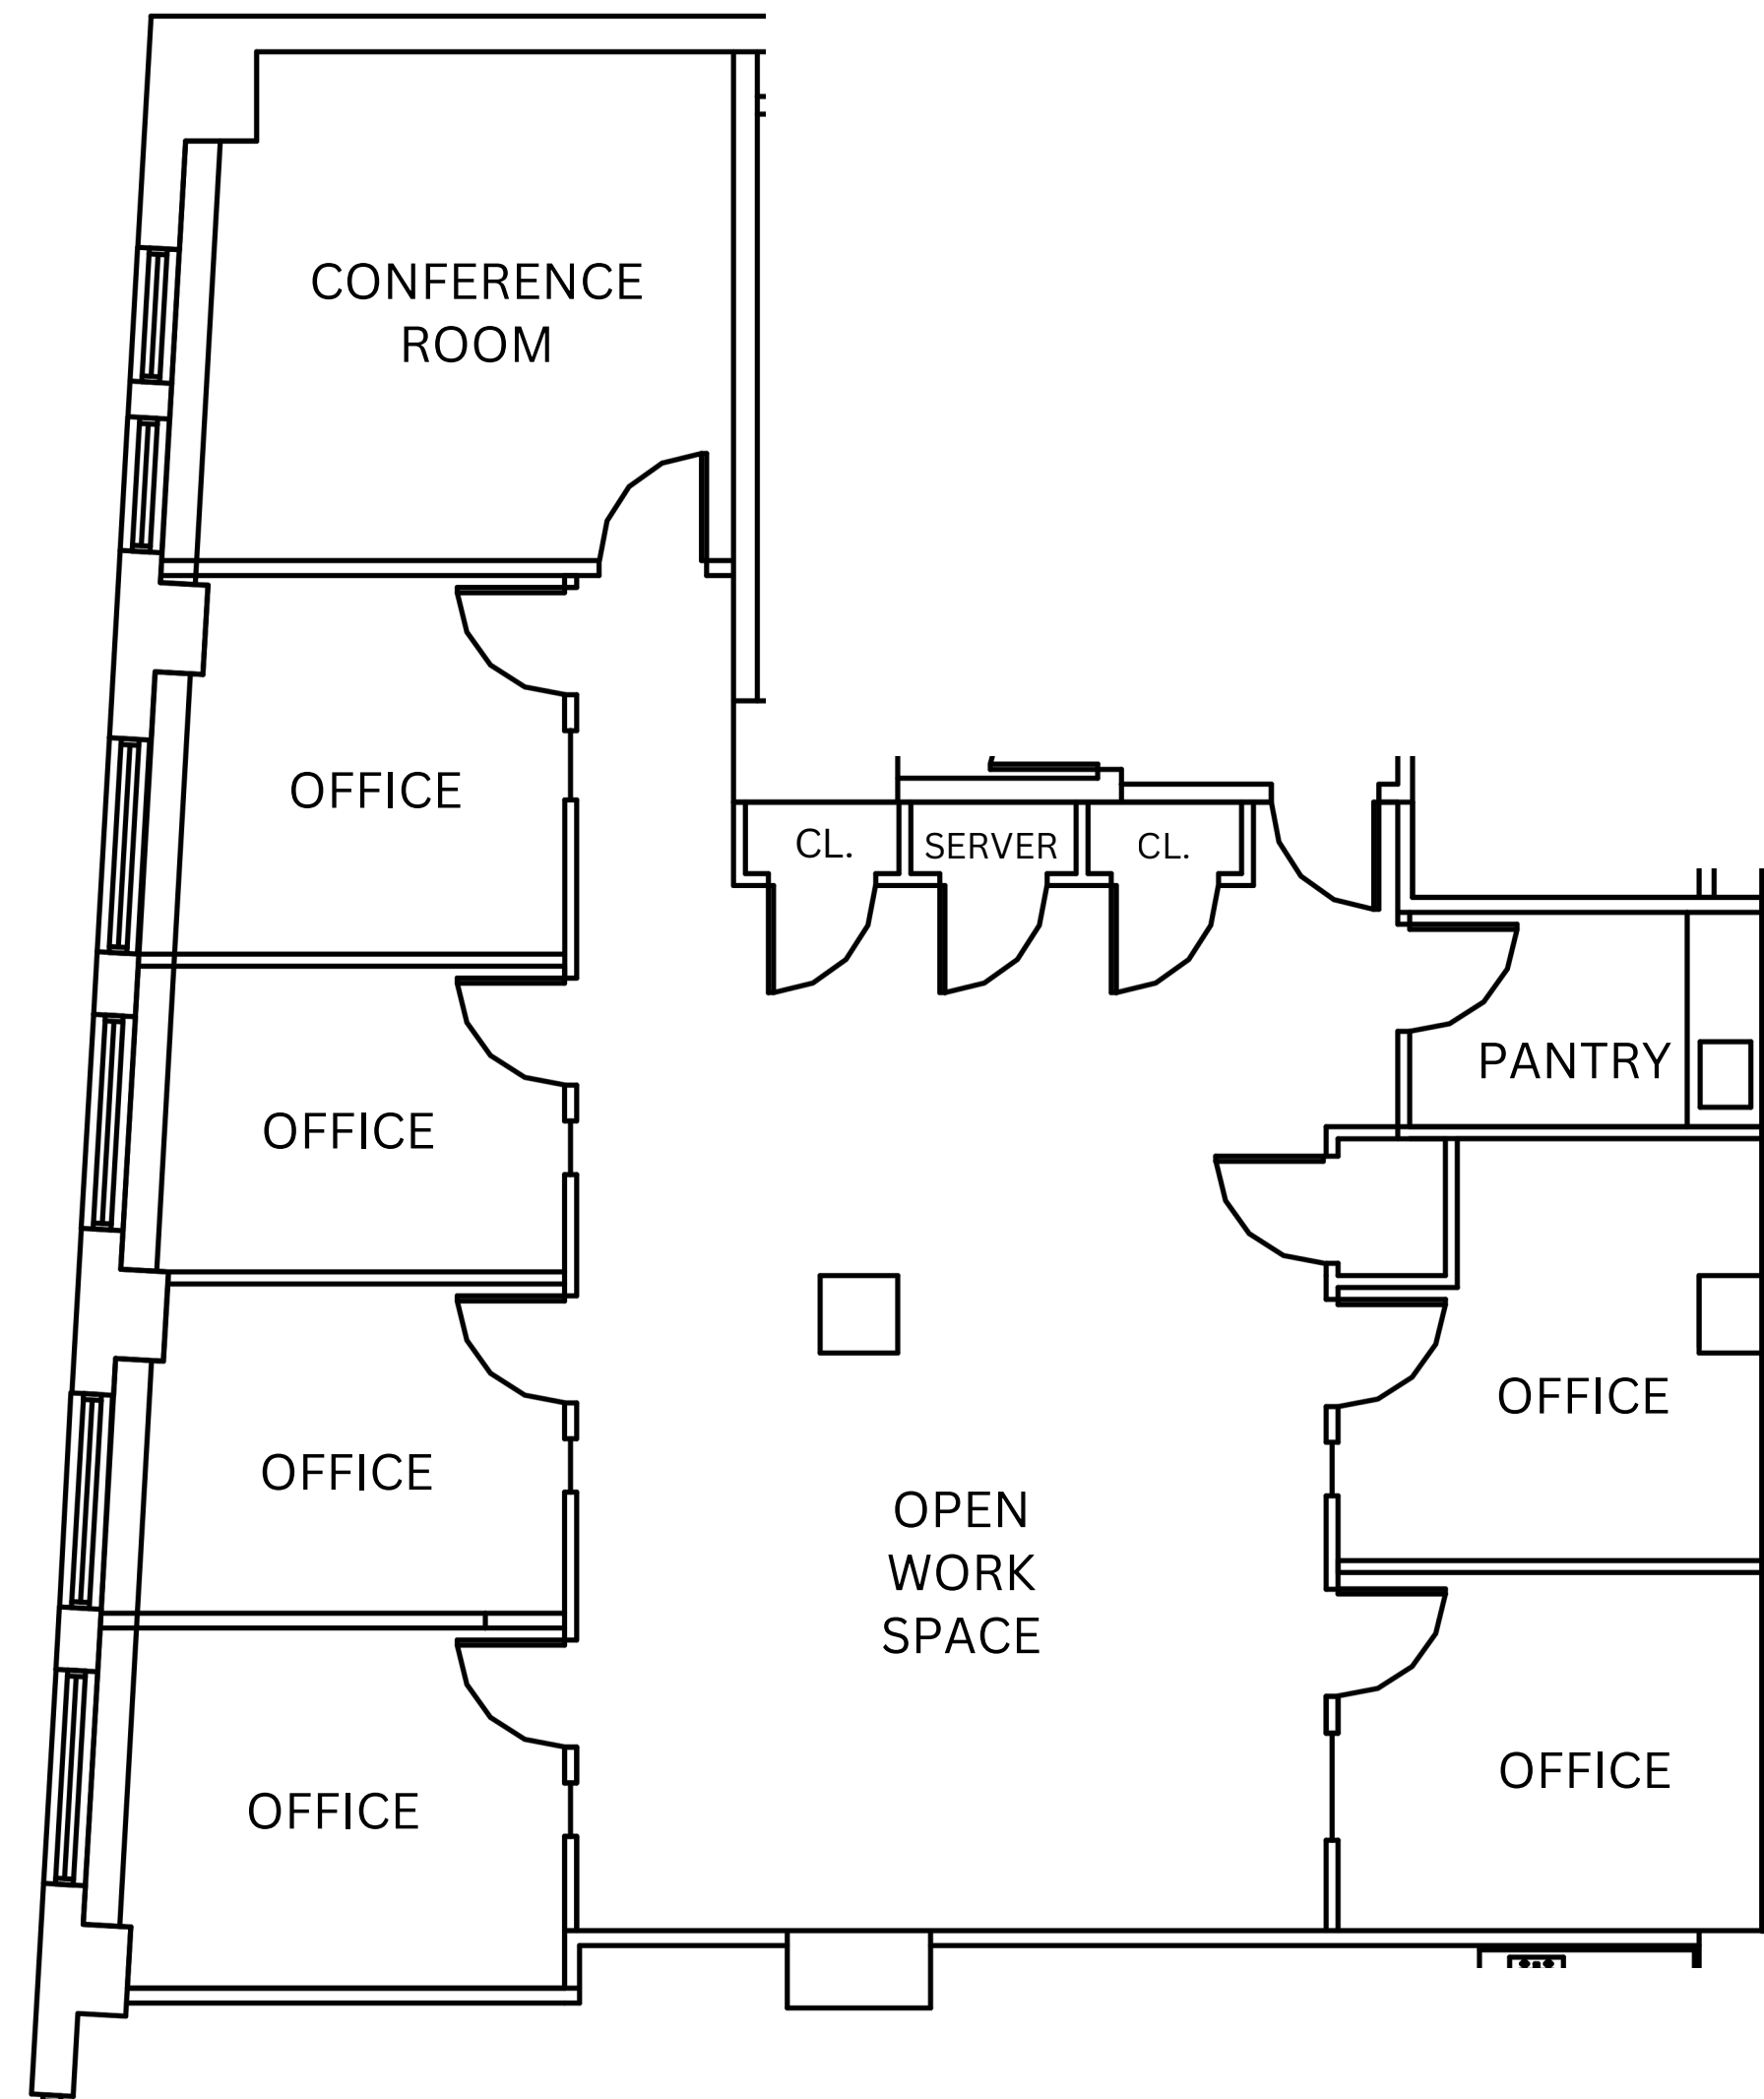

212-284-3756

www.cammebys.com

Cammeby's